




Elevation: 425

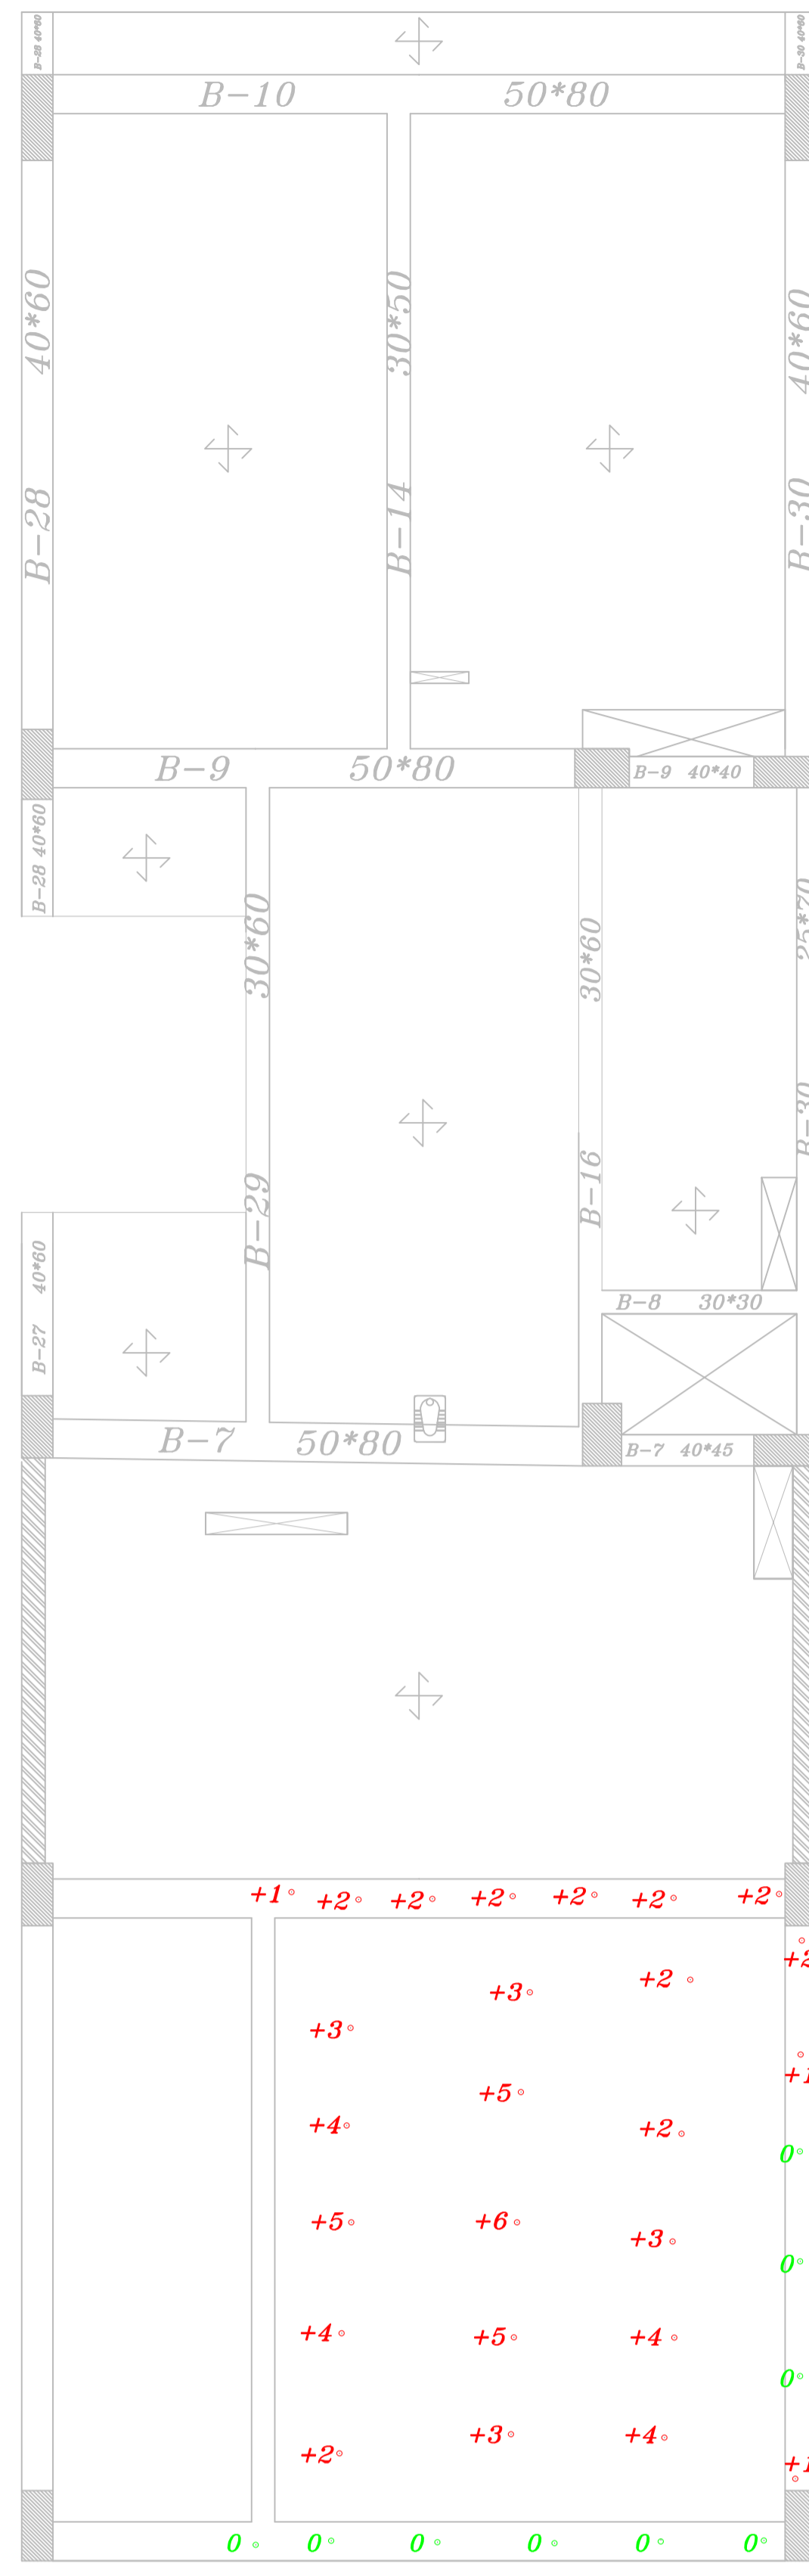


Elevation: 793

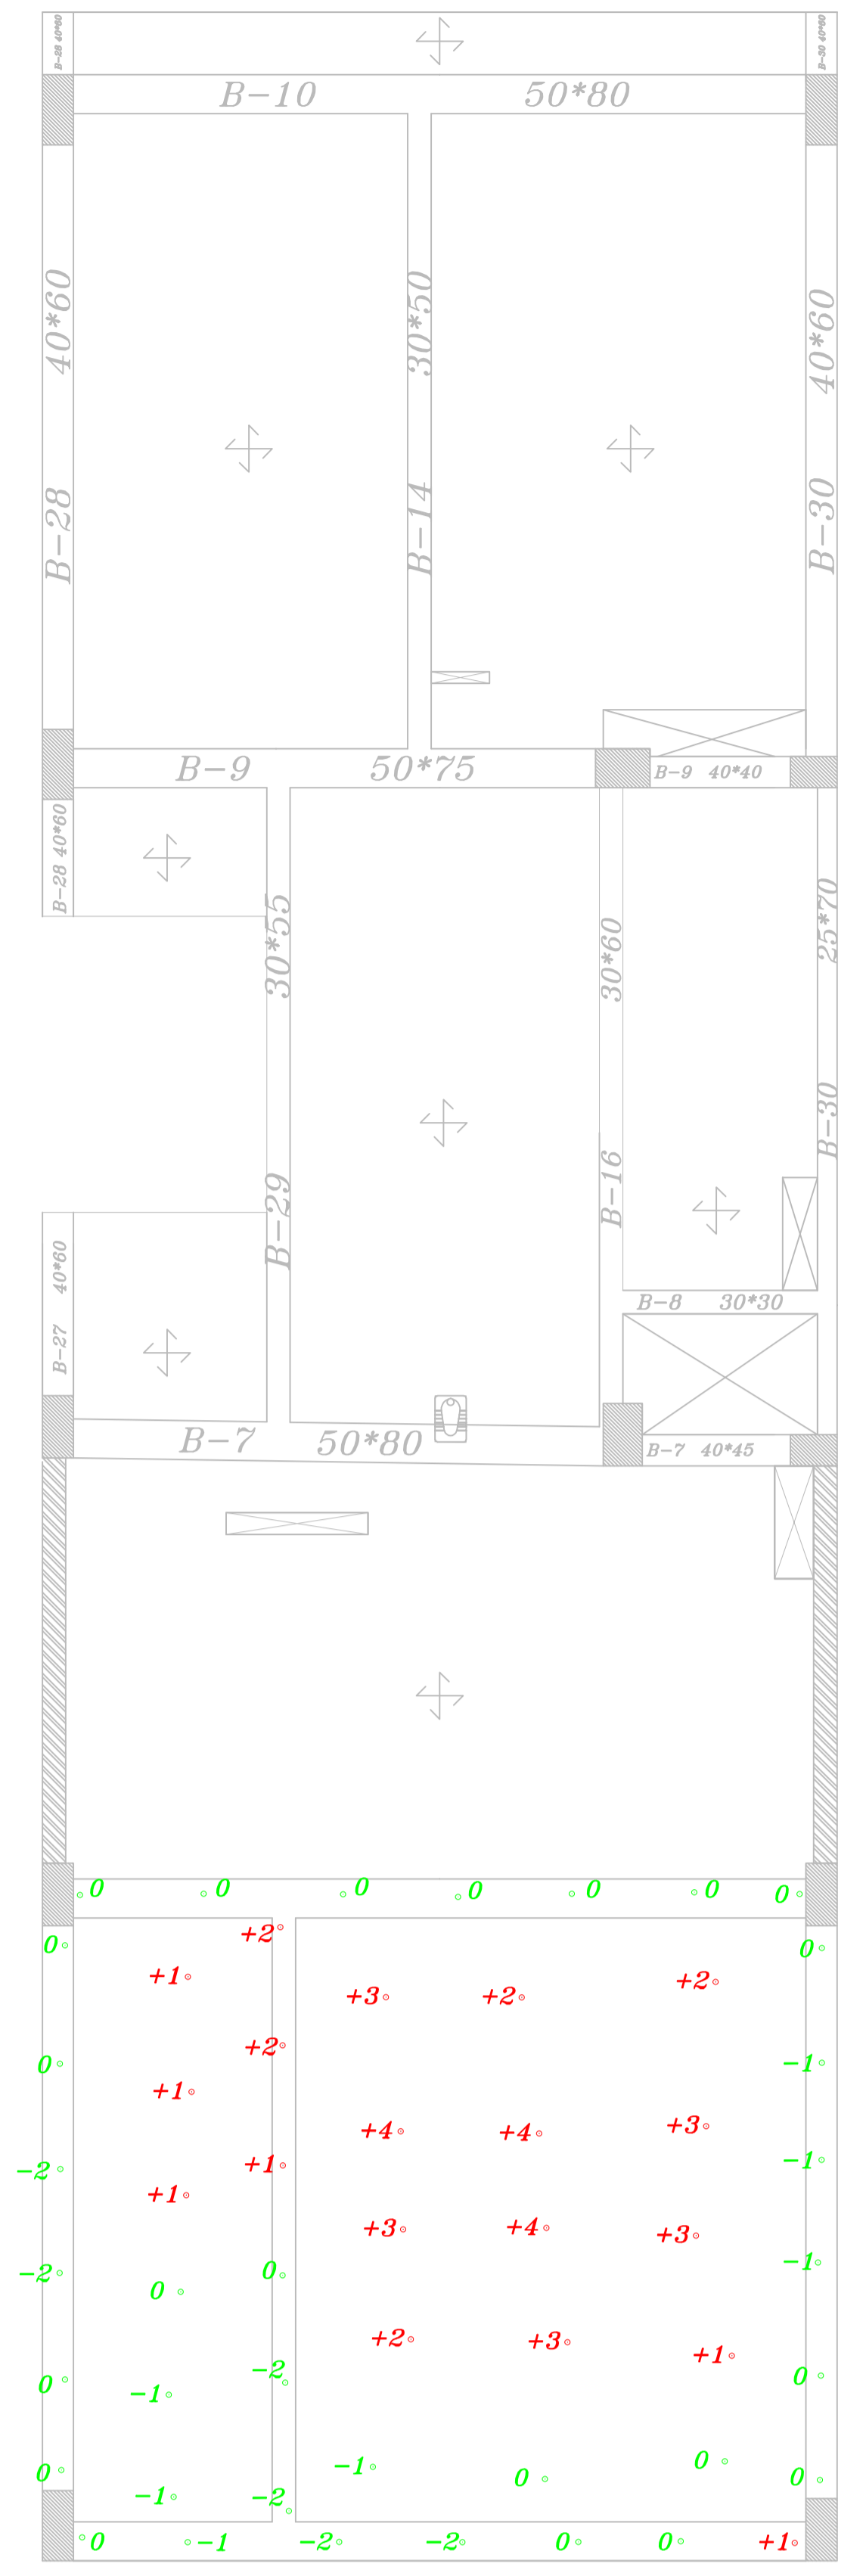


Elevation: 1161

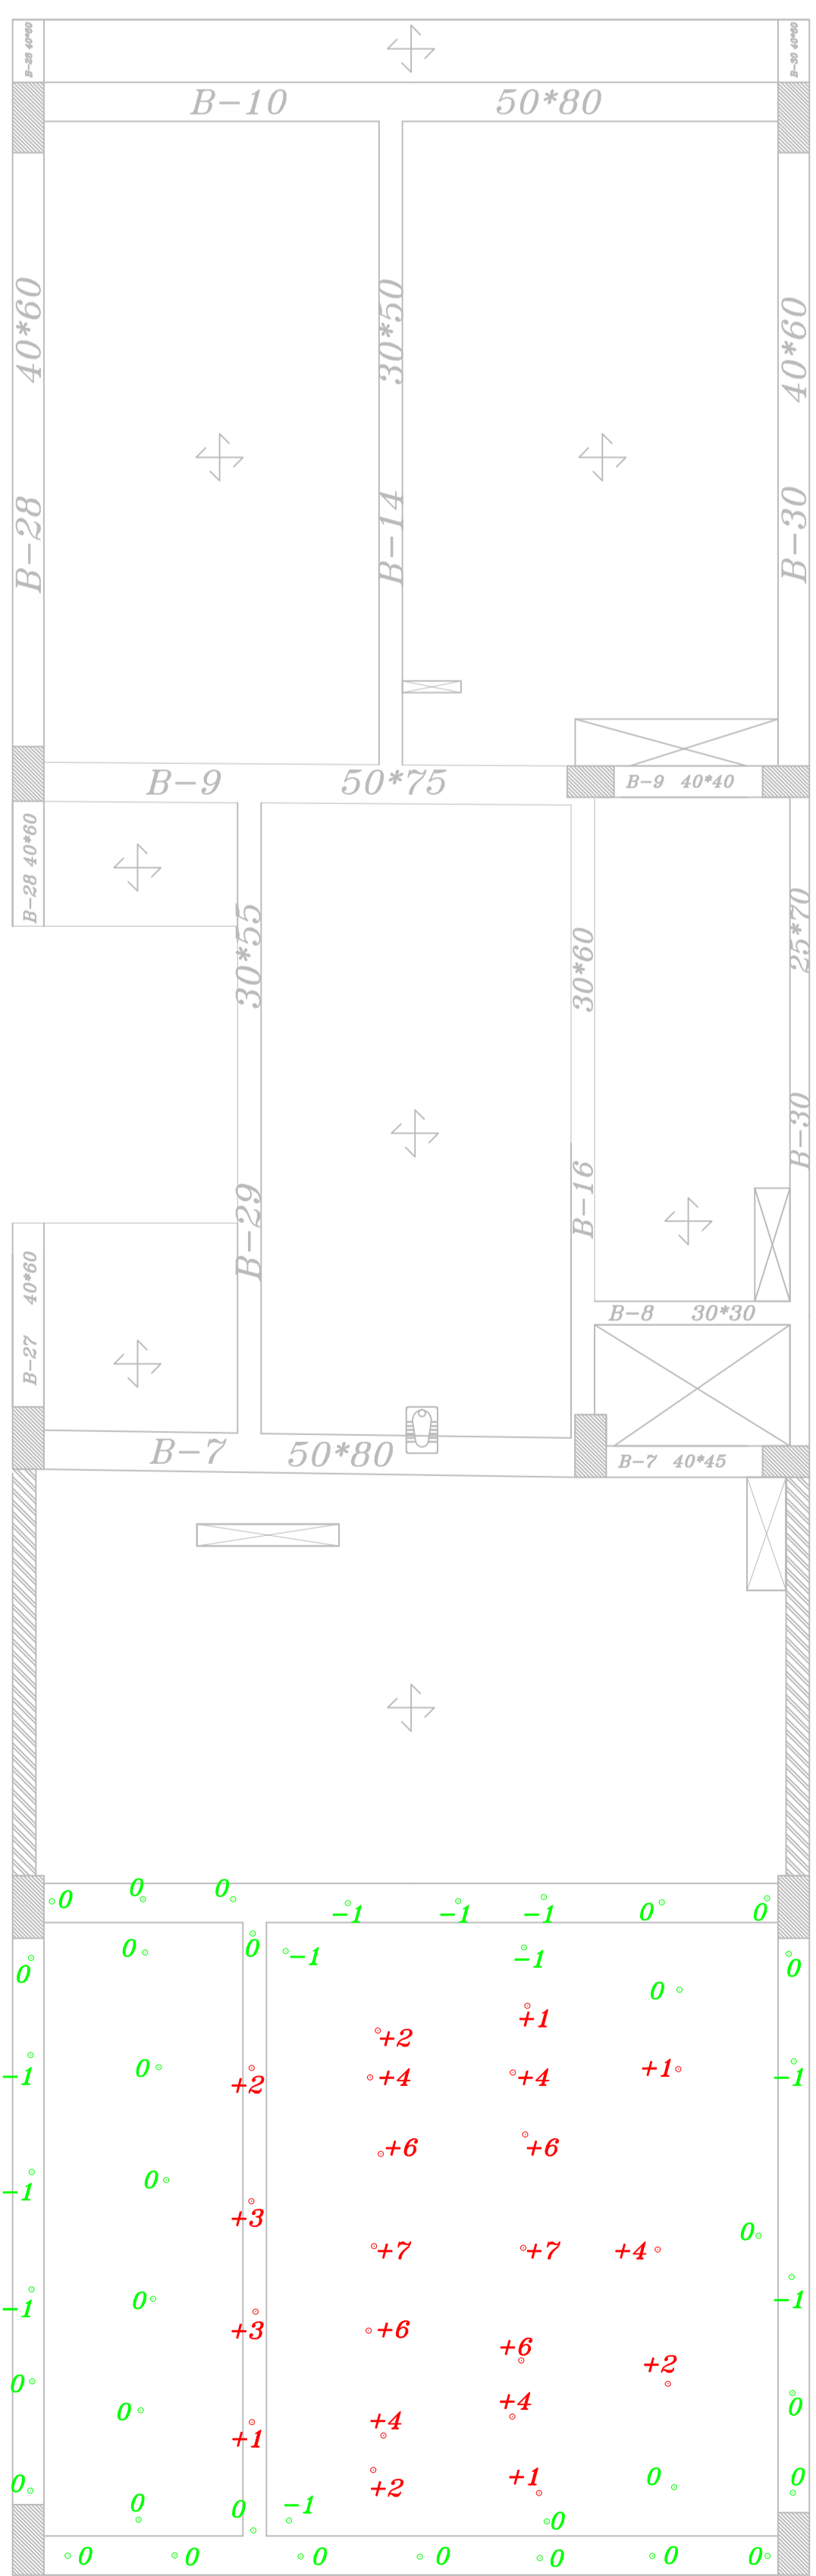

Elevation: 1529

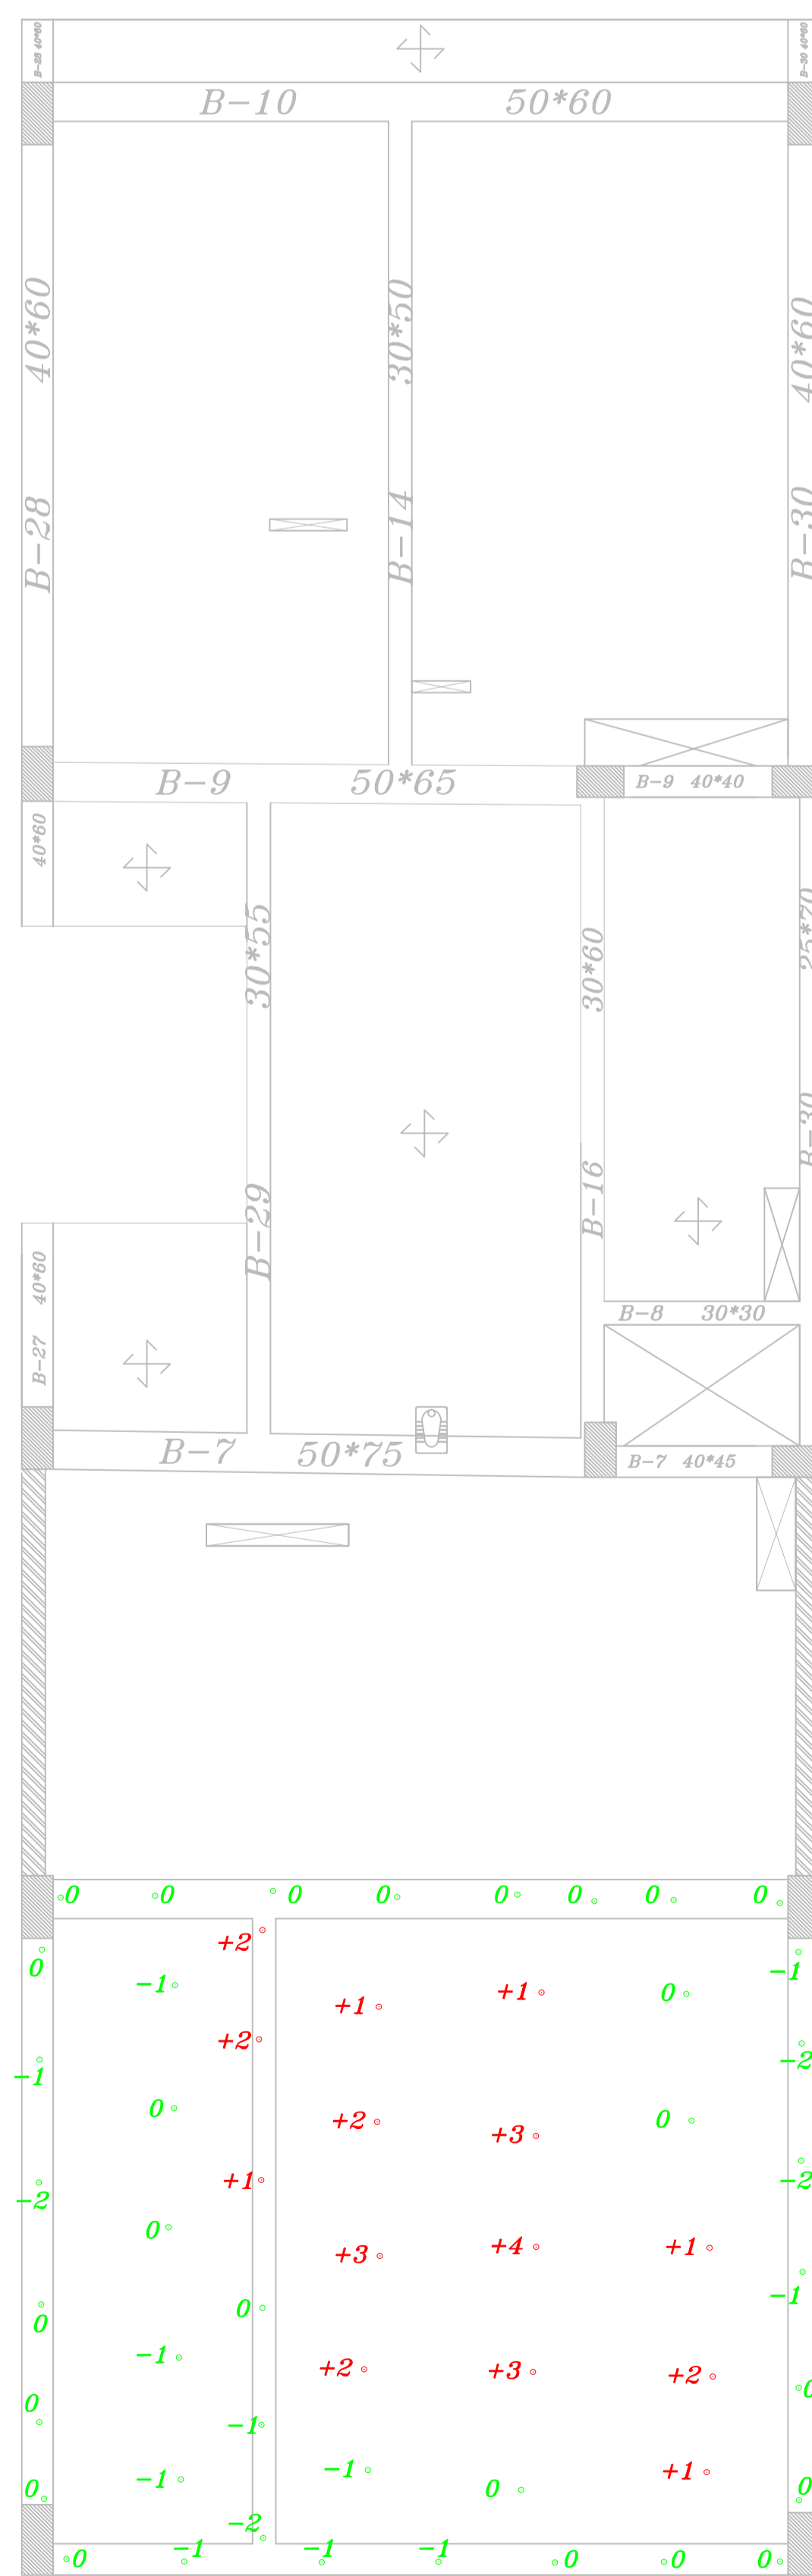

Elevation: +18.97

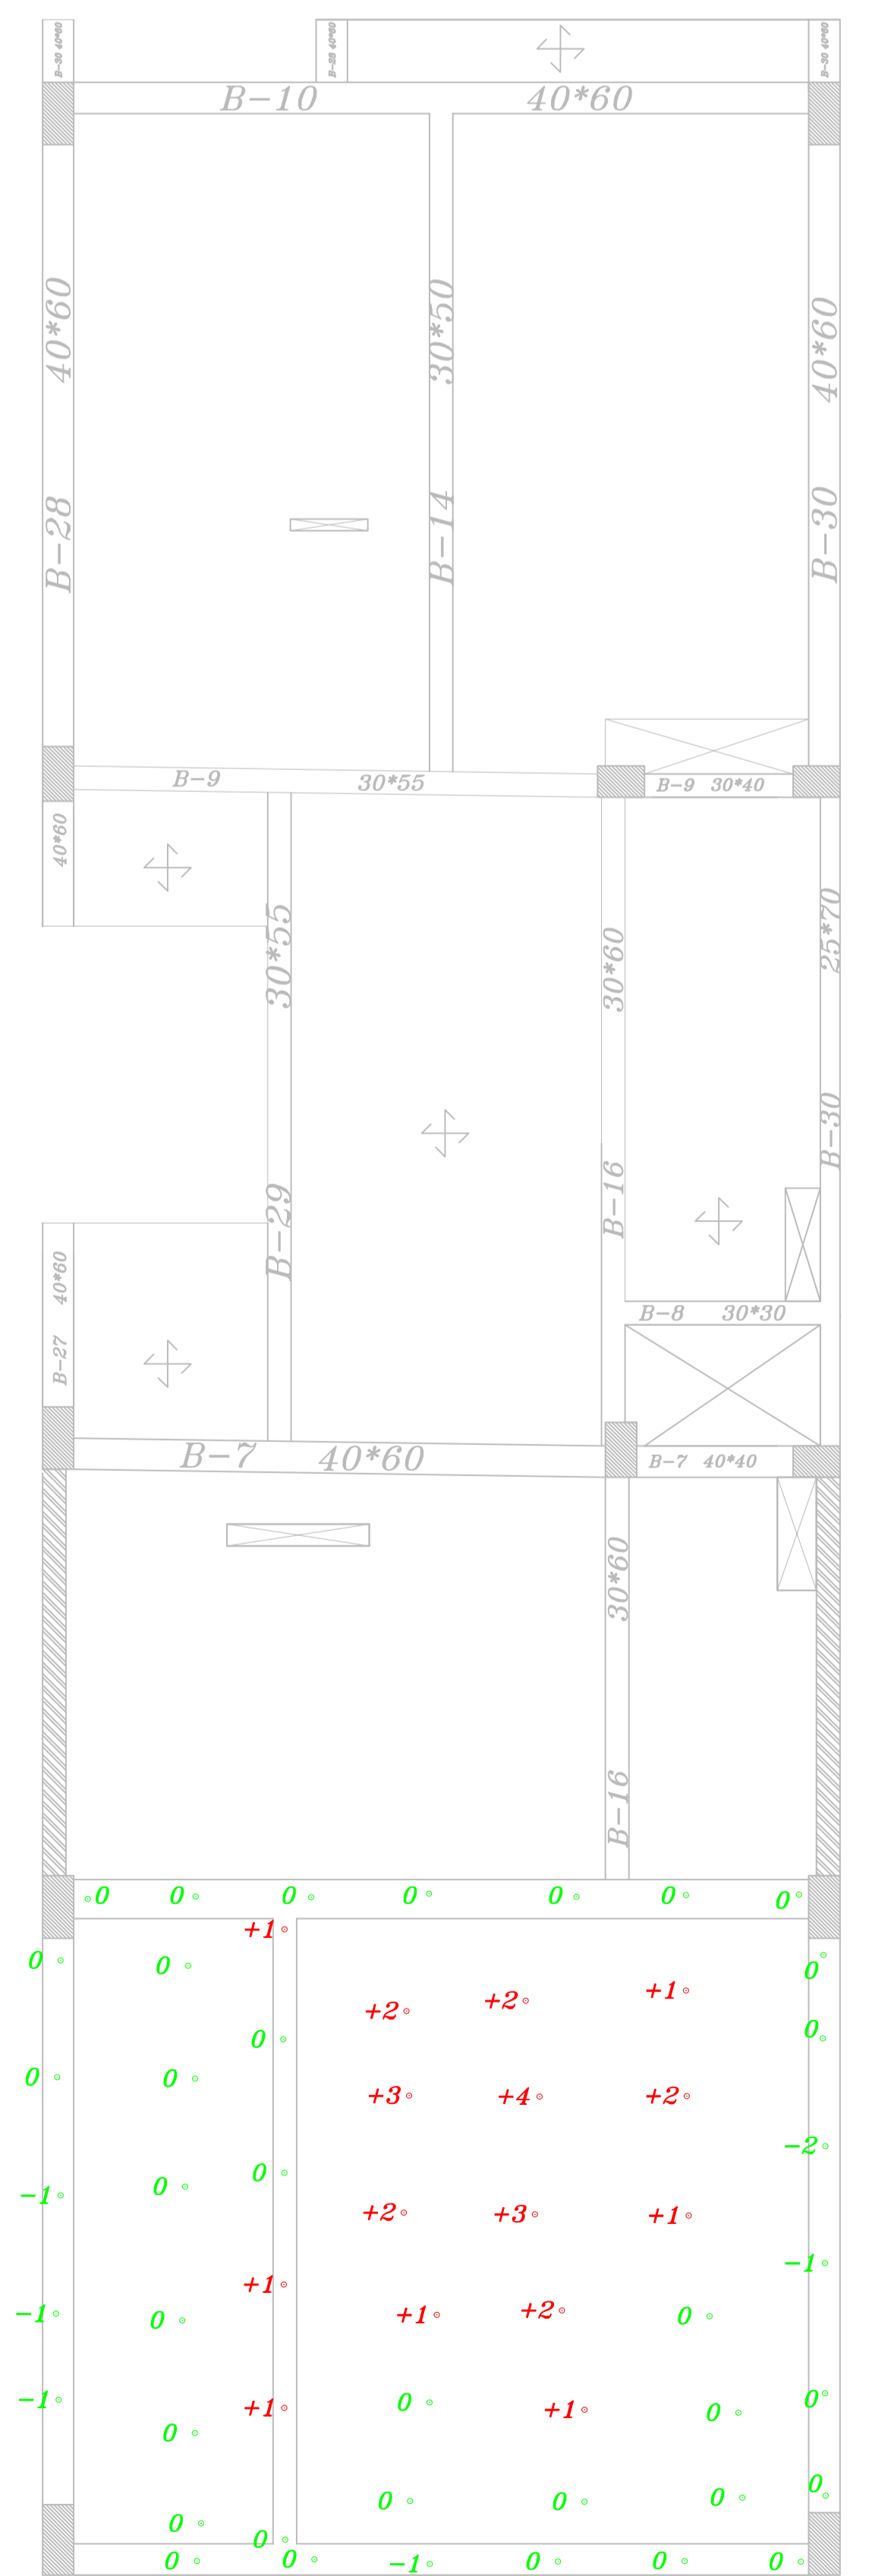

Elevation: +22.77